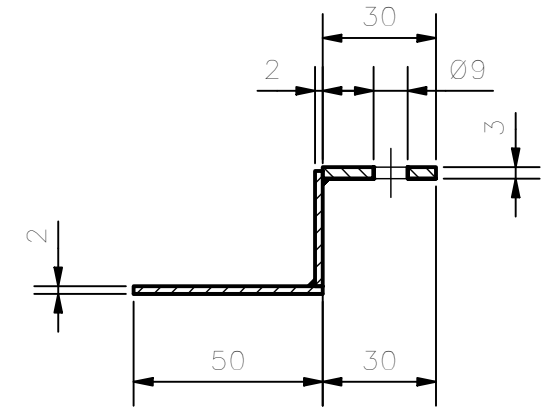
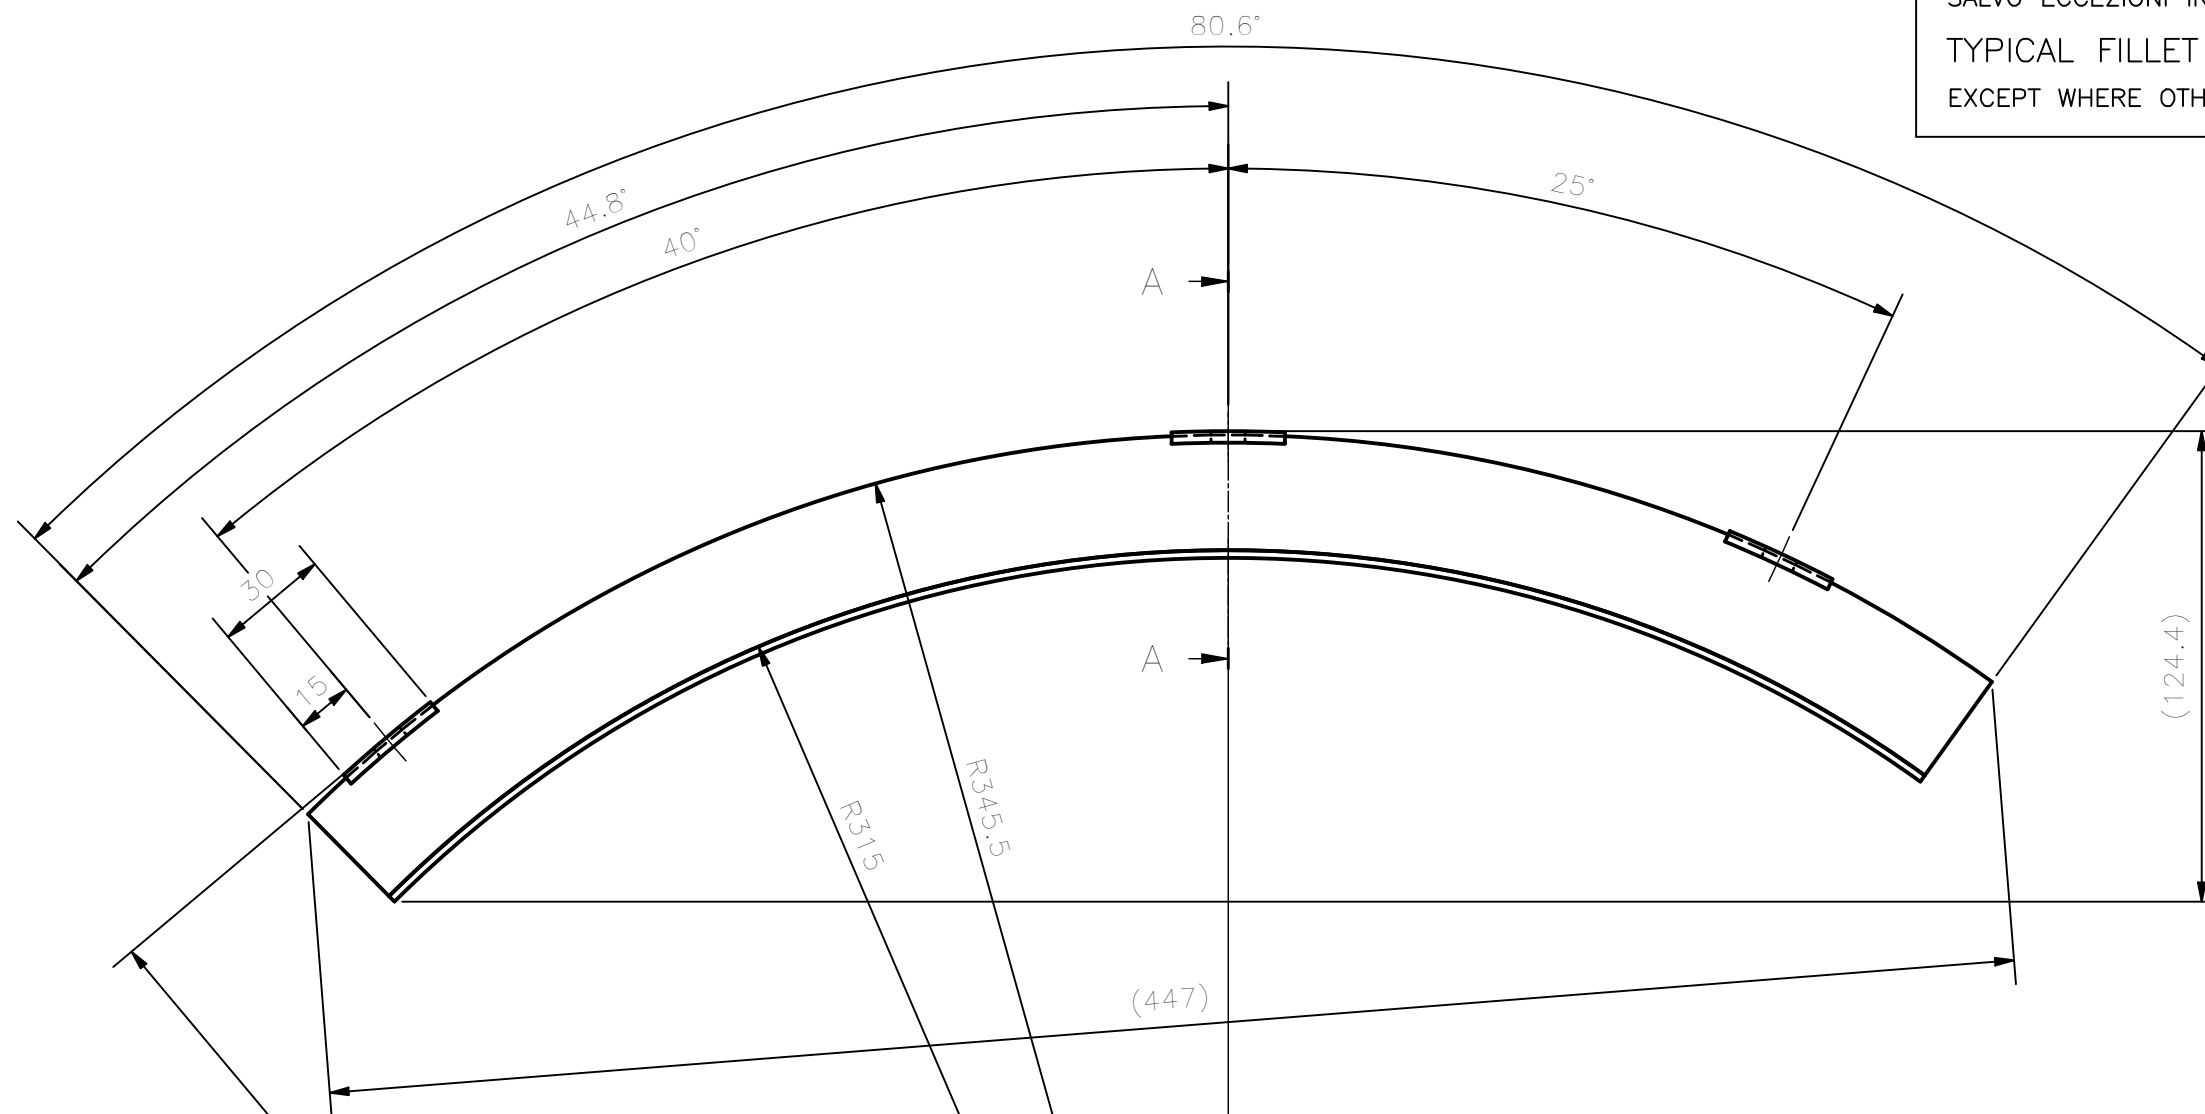
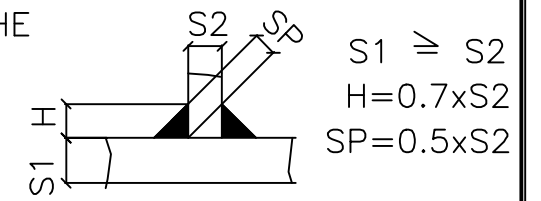

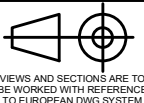


SALDATURE D'ANGOLO TIPICHE
 SALVO ECCEZIONI INDICATE
 TYPICAL FILLET WELDS
 EXCEPT WHERE OTHERWISE NOTED



SECTION A-A
 1 : 2

NOTE:
 DEBURRING OF NOT DIMENSIONED EDGES ARE STRICTLY REQUIRED.
 THE SURFACES NOT MACHINED MUST BE COATED WITH PAINTING TYPE RAL 3016.

 EIE GROUP via Torino 151A - Mestre Venezia - 30172 - ITALY tel. +39 041 5317906 - www.eie.it		 ASTRI mini-array - CTA Small Size Telescope prototypes												
Material: Welded construction steel S355J0 EN10027	Surface:	Tolerances according to: ISO 2768/1-m ISO 2768/2-k	Roughness:	Commissa/Job no.:	 VIEWS AND SECTIONS ARE TO BE WORKED WITH REFERENCE TO EUROPEAN DWG SYSTEM									
Status:		Mass: 0,63 kg	Scale: 1:2	G0113										
		Date:	Name:	Naming: Electro Mechanics Mount Assembly Protection 02 for strip encoder										
		Designed 03/01/2019	ACA											
		Checked 10/01/2019	ABU											
		Approved 10/01/2019	GPM											
<table border="1"> <thead> <tr> <th>Rev</th> <th>Modification</th> <th>Name</th> <th>Date</th> </tr> </thead> <tbody> <tr> <td>A</td> <td>First issue</td> <td>ACA</td> <td>04.03.21</td> </tr> </tbody> </table>		Rev	Modification	Name	Date	A	First issue	ACA	04.03.21	Drawing size:	A3	Drawing N.	7110-000-02-00	Sheet: 1 / 1
Rev	Modification	Name	Date											
A	First issue	ACA	04.03.21											
ALL RIGHTS BELONG TO EIE GROUP Srl NO COPIES, REPRODUCTION OR DISSEMINATION ARE PERMITTED.				Filename:	Carter 02 for strip encoder.ipt									