


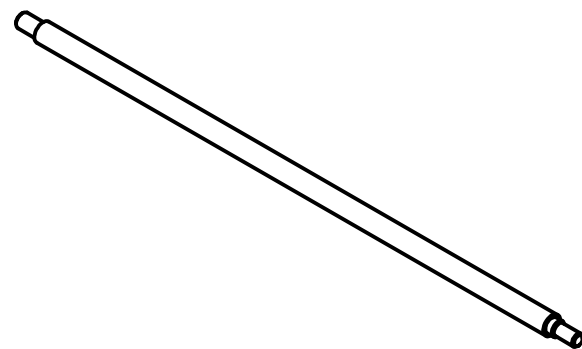

ISOMETRIC VIEW



NOTE:  
OBTAINED FROM WIRE DRAWING ROD.  
PROTECT WITH OIL.

 <b>EIE GROUP</b>		<b>EIE GROUP</b> via Torino 151A - Mestre Venezia - 30172 - ITALY tel. +39 041 5317906 - www.eie.it		 		<b>ASTRI mini-array - CTA Small Size Telescope prototypes</b>											
Material: Construction steel S355J0 EN10027		Surface:		Tolerances according to: ISO 2768/1-m ISO 2768/2-k		Roughness:		Compressa/Job no.: <b>G0113</b>									
Status:		Mass: 0,79 kg		Scale: 1:2		Naming: Electro Mechanics Base structure Base door threaded rod											
		Date: Designed 15/01/2014 Checked 24/02/2014 Approved 24/02/2014		Name: SG AB GPM		Drawing N. <b>7111-100-13-00</b>		Sheet: <b>1 / 1</b>									
<table border="1"> <thead> <tr> <th>Rev</th> <th>Modification</th> <th>Name</th> <th>Date</th> </tr> </thead> <tbody> <tr> <td>A</td> <td>First issue</td> <td>ACA</td> <td>04.03.21</td> </tr> </tbody> </table>		Rev	Modification	Name	Date	A	First issue	ACA	04.03.21	Drawing size: <b>A3</b>		Filename: Door threaded rod.ipt					
Rev	Modification	Name	Date														
A	First issue	ACA	04.03.21														
ALL RIGHTS BELONG TO EIE GROUP Srl NO COPIES, REPRODUCTION OR DISSEMINATION ARE PERMITTED.																	