

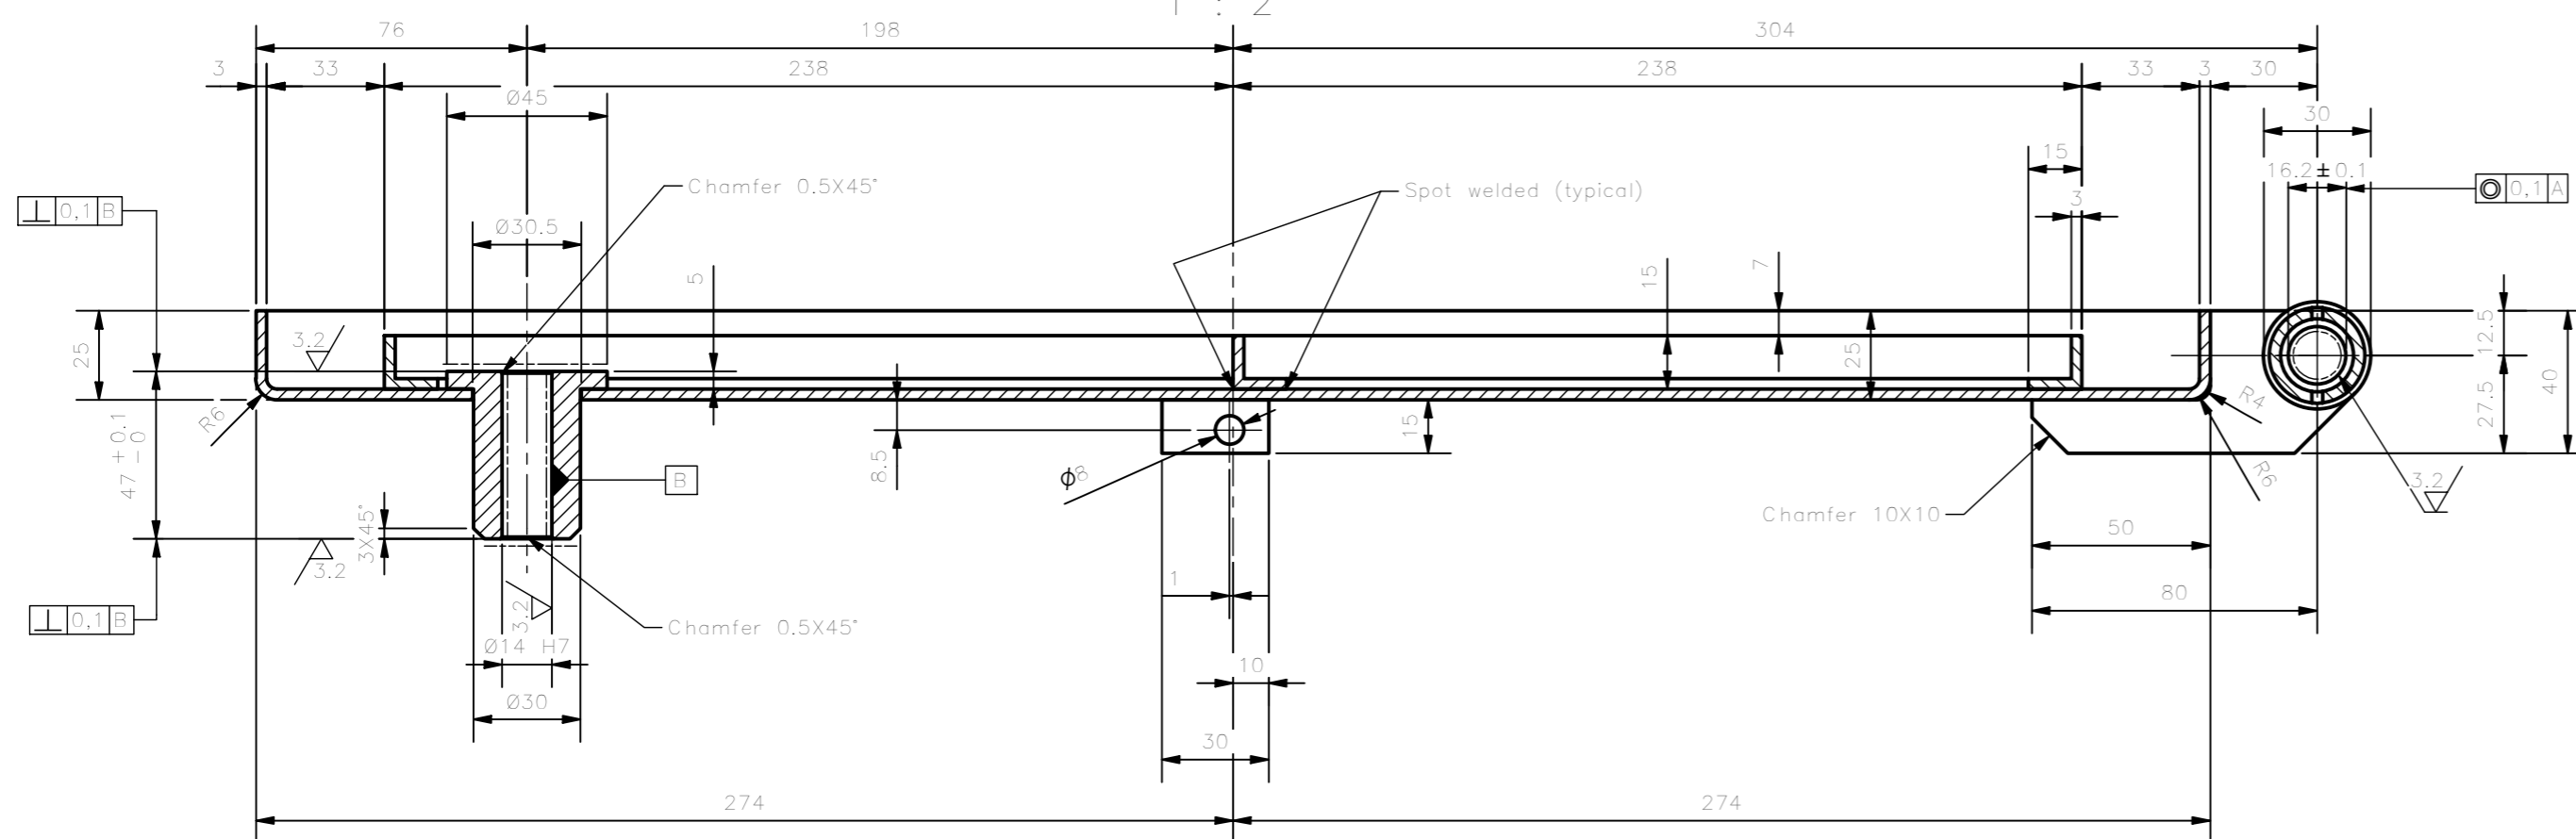


ISOMETRIC VIEW

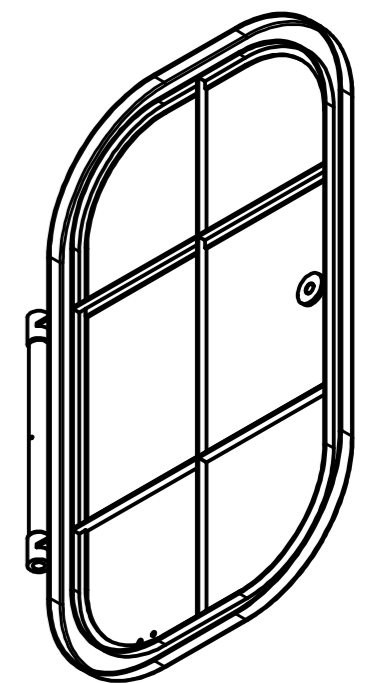

----- SURFACES ARE NOT PAINTED
THE SURFACES NOT MACHINED MUST BE COATED WITH PAINTING TYPE RAL 3016.

SALDATE D'ANGOLO TIPICHE
SALVO ECCEZIONI INDICATE
TYPICAL FILLET WELDS
EXCEPT WHERE OTHERWISE NOTED

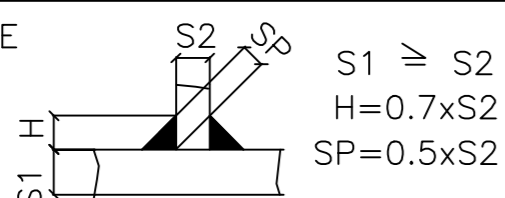

		EIE GROUP via Torino 151A - Mestre Venezia - 30172 - ITALY tel. +39 041 5317906 - www.eie.it				ASTRI mini-array - CTA Small Size Telescope prototypes	
Material: Construction steel S355J0 EN10027	Surface: Painted	Tolerances according to: ISO 2768/1-m ISO 2768/2-k	Roughness: 3.2	Commissa/Job no.: G0113			
Status:	Mass: 16,61 kg	Scale: 1:5 1:2	Naming: Mount Assembly Base structure Base Base door structure				
1 First Issue ACA 04.03.21 Rev. Modification Name Date		Date: 13/01/2014	Name: SG	Drawing N. 7111-110-01-00			
		Checked: 15/01/2014	AB	Sheet: 1/1			
		Approved: 15/01/2014	GPM	Drawing size: A2			
ALL RIGHTS BELONG TO EIE GROUP Srl NO COPIES, REPRODUCTION OR DISSEMINATION ARE PERMITTED.				Filename: Base door.ipt			