


ISOMETRIC VIEW

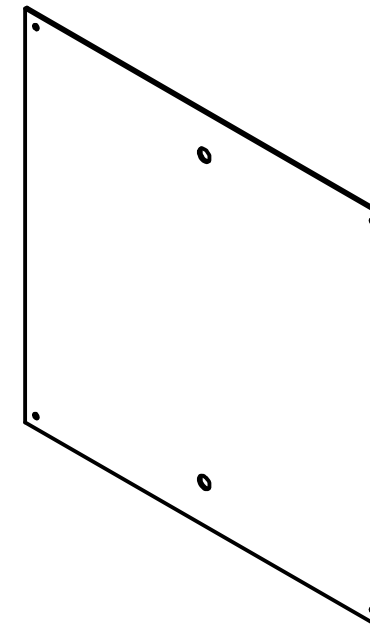

NOTE:  
DEBURRING OF NOT DIMENSIONED EDGES ARE STRICTLY REQUIRED.  
THE SURFACES NOT MACHINED MUST BE COATED WITH PAINTING TYPE RAL 3016.

 <b>EIE GROUP</b>		<b>EIE GROUP</b> via Torino 151A - Mestre Venezia - 30172 - ITALY tel. +39 041 5317906 - www.eie.it				 <b>ASTRI mini-array - CTA Small Size Telescope prototypes</b>									
Material: Construction steel S355J0 EN10027	Surface:	Tolerances according to: ISO 2768/1-m ISO 2768/2-k	Roughness:	Commissa/Job no.:		<b>G0113</b>									
Status:		Mass: 10,55 kg	Scale: 1:5	Naming: Optical Support Structure AZ Fork AZ Fork Structure Cabinets Support Cover											
		Date:	Name:												
		Designed 08/01/2018	ACA												
		Checked 07/02/2018	ABU												
		Approved 07/02/2018	GPM	Drawing N.		<b>73113-110-07-00</b>									
<table border="1"> <thead> <tr> <th>Rev</th> <th>Modification</th> <th>Name</th> <th>Date</th> </tr> </thead> <tbody> <tr> <td>A</td> <td>First issue</td> <td>ACA</td> <td>04.03.21</td> </tr> </tbody> </table>		Rev	Modification	Name	Date	A	First issue	ACA	04.03.21	Drawing size:	A3	Sheet:		<b>1 / 1</b>	
Rev	Modification	Name	Date												
A	First issue	ACA	04.03.21												
ALL RIGHTS BELONG TO EIE GROUP Srl NO COPIES, REPRODUCTION OR DISSEMINATION ARE PERMITTED.				Filename: Cabinets support cover.ipt											