




SECTION A-A
1 : 2

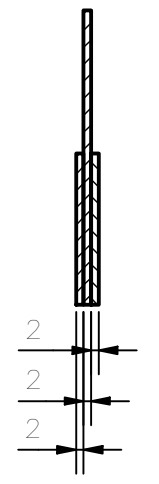

ISOMETRIC VIEW

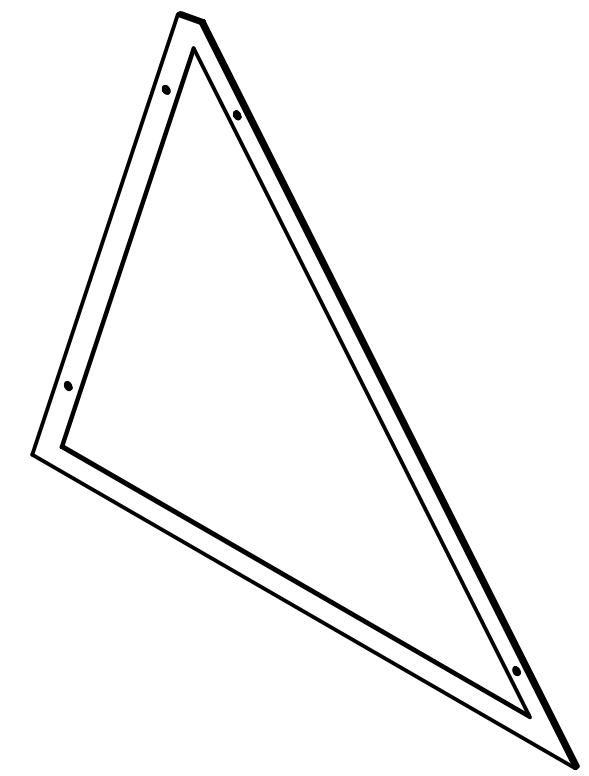

NOTES:
1) DEBURRING OF NOT DIMENSIONED EDGES ARE STRICTLY REQUIRED
2) THE SURFACES MUST BE COATED WITH PAINTING TYPE RAL 3016 UNLESS OTHERWISE SPECIFIED

 EIE GROUP via Torino 151A - Mestre Venezia - 30172 - ITALY tel. +39 041 5317906 - www.eie.it		  ASTRI mini-array - CTA Small Size Telescope prototypes										
Material: Welded EN AW-5083	Surface:	Tolerances according to: ISO 2768/1-m ISO 2768/2-k	Roughness:	Commissa/Job no.: G0113								
Status:	Mass: 3,69 kg	Scale: 1:5	Naming: Electro Mechanics Optical Support Structure M2 BUS Main Structure M2 shield 2									
<table border="1"> <tr> <td>A</td> <td>First issue</td> <td>ACA</td> <td>04.03.21</td> </tr> <tr> <td>Rev</td> <td>Modification</td> <td>Name</td> <td>Date</td> </tr> </table>		A	First issue	ACA	04.03.21	Rev	Modification	Name	Date	Date: 02/02/2017	Name: ABU	Drawing N. 7124-000-06-00 Sheet: 1 / 1
A	First issue	ACA	04.03.21									
Rev	Modification	Name	Date									
Drawing size: A3		Checked: 15/10/2018 ABU	Approved: 16/10/2018 GPM									
ALL RIGHTS BELONG TO EIE GROUP Srl NO COPIES, REPRODUCTION OR DISSEMINATION ARE PERMITTED.				Filename: M2 shield 2.ipt								