



SECTION A-A
1 : 2



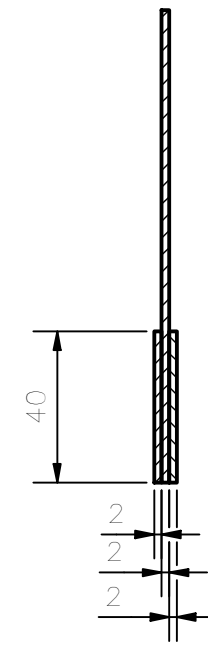

ISOMETRIC VIEW

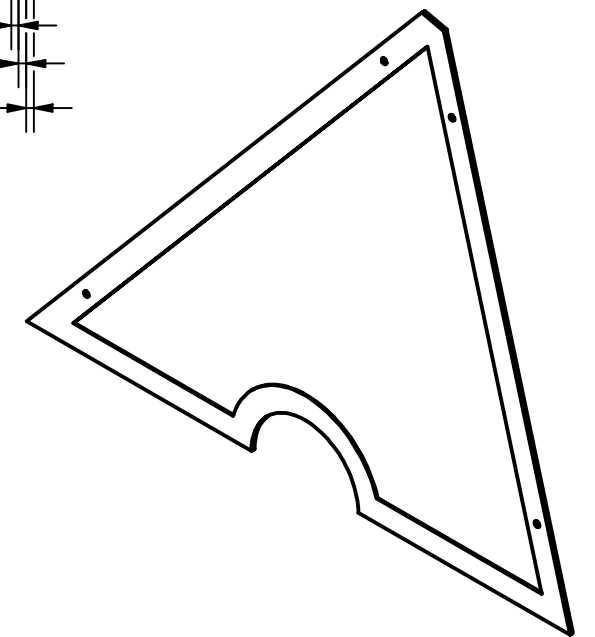

NOTES:

- 1) DEBURRING OF NOT DIMENSIONED EDGES ARE STRICTLY REQUIRED
- 2) THE SURFACES MUST BE COATED WITH PAINTING TYPE RAL 3016 UNLESS OTHERWISE SPECIFIED

| | | | | | | | | | | | | | |
|--|------------------|--|---|-----------------------------------|----------|------------|--------------|----------|------------|---------------------|---------------------|------------------------------|-------------------------------------|
|  EIE GROUP via Torino 151A - Mestre Venezia - 30172 - ITALY tel. +39 041 5317906 - www.eie.it | |   ASTRI mini-array - CTA Small Size Telescope prototypes | | | | | | | | | | | |
| Material: Welded EN AW-5083 | Surface: | Tolerances according to: ISO 2768/1-m ISO 2768/2-k | Roughness: | Commissa/Job no.: G0113 | | | | | | | | | |
| Status: | Mass: 3,70 kg | Scale: 1:10 | Naming: Electro Mechanics Optical Support Structure M2 BUS Main Structure M2 shield 3 | | | | | | | | | | |
| <table border="1"> <tr> <td>Designed</td> <td>02/02/2017</td> <td>ABU</td> </tr> <tr> <td>Checked</td> <td>15/10/2018</td> <td>ABU</td> </tr> <tr> <td>Approved</td> <td>16/10/2018</td> <td>GPM</td> </tr> </table> | | Designed | 02/02/2017 | ABU | Checked | 15/10/2018 | ABU | Approved | 16/10/2018 | GPM | Date: 16/10/2018 | Name: GPM | Drawing N. 7124-000-07-00 |
| Designed | 02/02/2017 | ABU | | | | | | | | | | | |
| Checked | 15/10/2018 | ABU | | | | | | | | | | | |
| Approved | 16/10/2018 | GPM | | | | | | | | | | | |
| <table border="1"> <tr> <td>A</td> <td>First issue</td> <td>ACA</td> <td>04.03.21</td> </tr> <tr> <td>Rev</td> <td>Modification</td> <td>Name</td> <td>Date</td> </tr> </table> | | A | First issue | ACA | 04.03.21 | Rev | Modification | Name | Date | Drawing size: A3 | Sheet: 1 / 1 | Filename: M2 shield 3.ipt | |
| A | First issue | ACA | 04.03.21 | | | | | | | | | | |
| Rev | Modification | Name | Date | | | | | | | | | | |
| ALL RIGHTS BELONG TO EIE GROUP Srl NO COPIES, REPRODUCTION OR DISSEMINATION ARE PERMITTED. | | | | | | | | | | | | | |

