
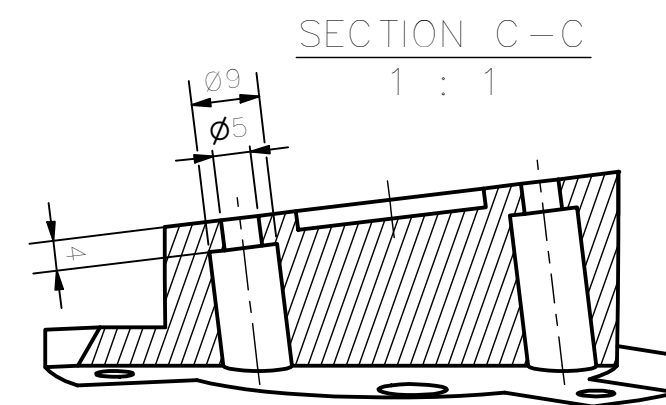
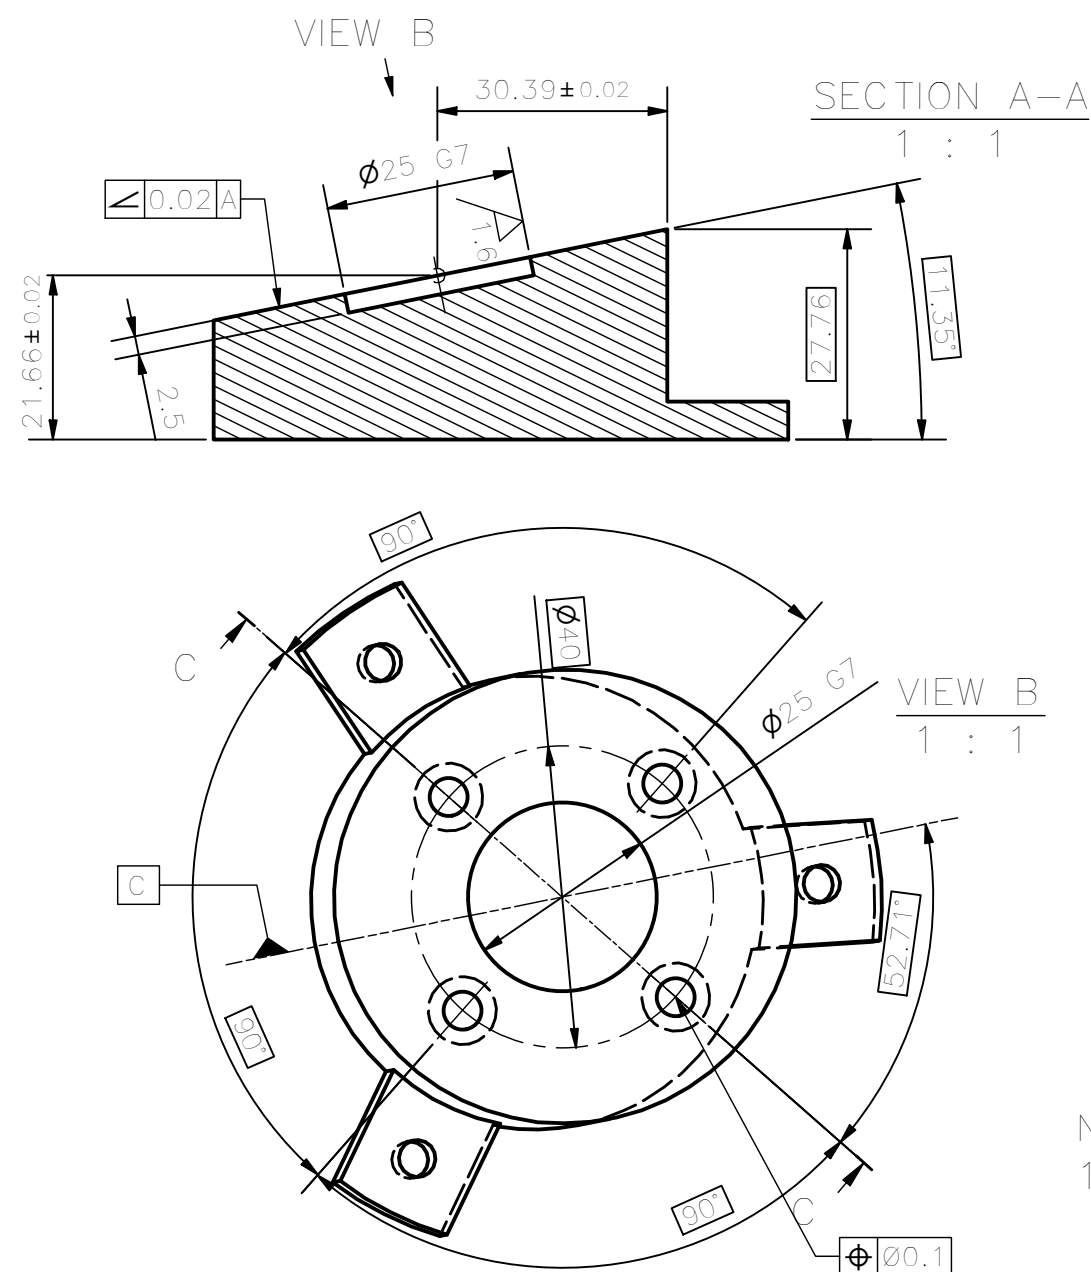


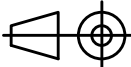

NOTES:
1) DEBURRING OF NOT DIMENSIONED
EDGES ARE STRICTLY REQUIRED.

$$3.2 \swarrow (1.6 \swarrow$$

 EIE GROUP		EIE GROUP via Torino 151A - Mestre Venezia - 30172 - ITALY tel. +39 041 5317906 - www.eie.it		 ASTRI		ASTRI mini-array - CTA Small Size Telescope prototypes									
Material: Stainless steel AISI 316L		Surface:		Tolerances according to: ISO 2768/1-m ISO 2768/2-k		Roughness:									
				Commessa/Job no.: G0113		 VIEWS AND SECTIONS ARE TO BE WORKED WITH REFERENCE TO EUROPEAN DWG SYSTEM									
Status:		Mass: 0,46 kg		Scale: 1:1		Naming: Electro Mechanics Optical Support Structure M1 Segment Support Assembly Wedge 3°ring									
				Date:		Name:									
		Designed		24/11/2018		ACA									
		Checked		04/01/2019		ABU									
		Approved		04/01/2019		GPM									
<table border="1"> <tr> <td>A</td> <td>First issue</td> <td>ACA</td> <td>04.03.21</td> </tr> <tr> <td>Rev</td> <td>Modification</td> <td>Name</td> <td>Date</td> </tr> </table>		A	First issue	ACA	04.03.21	Rev	Modification	Name	Date	Drawing size:		A3		Drawing N. 7125-000-17-00	
A	First issue	ACA	04.03.21												
Rev	Modification	Name	Date												
						Sheet: 1 / 1									
ALL RIGHTS BELONG TO EIE GROUP Srl NO COPIES, REPRODUCTION OR DISSEMINATION ARE PERMITTED.				Filename: Wedge 3°ring.ipt											