


ISOMETRIC VIEW

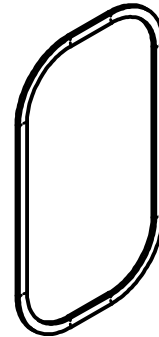

EIE GROUP

via Torino 151A - Mestre
Venezia - 30172 - ITALY
tel. +39 041 5317906 - www.eie.it



ASTRI mini-array - CTA Small Size Telescope prototypes

Material: EPDM Rubber Shore 30		Surface:	Tolerances according to: ISO 2768/1-m ISO 2768/2-k	Roughness:	Commissa/Job no.: G0113	<p>IEWS AND SECTIONS ARE TO BE WORKED WITH REFERENCE TO EUROPEAN DWG SYSTEM</p>
Status:		Mass: 0,61 kg	Scale: 1:10	Naming: Base structure Base Base door Door gasket		
		Date:	Name:	Drawing N.		Sheet: 1 / 1
		Designed 08/01/2014	SG	7111-110-03-00		
		Checked 09/01/2014	AB	Drawing size: A4		
		Approved 10/01/2014	GPM	Filename: Door rubber.ipt		
A	First Issue	ACA	04.03.21			
Rev	Modification	Name	Date			

ALL RIGHTS BELONG TO EIE GROUP Srl
NO COPIES, REPRODUCTION OR DISSEMINATION ARE PERMITTED.

1

2

3