SECTION A–A

1 : 1

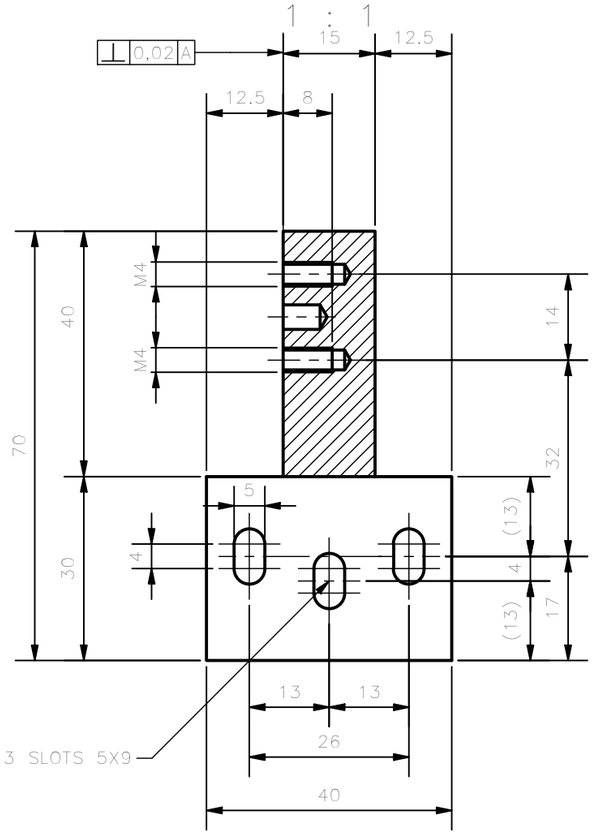

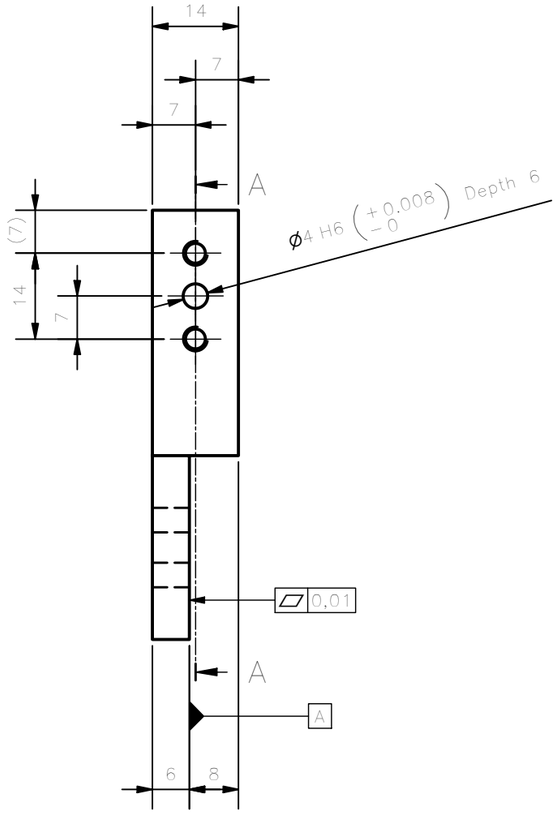

ISOMETRIC VIEW

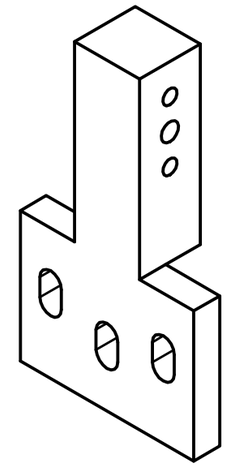

3,2

NOTE:

UNCOATED SURFACES MACHINED MUST BE PROTECTED WITH OIL.

EIE GROUP

EIE GROUP
via Torino 151A - Mestre
Venezia - 30172 - ITALY
tel. +39 041 5317906 - www.eie.it

ASTRI mini-array - CTA Small Size Telescope prototypes

Material: Construction steel S355J0 EN10027	Surface:	Tolerances according to: ISO 2768/1-m ISO 2768/2-k	Roughness:	Commessa/Job no.: G0113	VIEWS AND SECTIONS ARE TO BE WORKED WITH REFERENCE TO EUROPEAN DWG SYSTEM
Status:		Mass: 0,11 kg	Scale: 1:1	Naming: Mount Assembly / Base structure / Base / Az encoder head support	
		Designed 13/01/2014 SG Checked 20/02/2014 AB Approved 20/02/2014 GPM			
A First Issue ACA 04.03.21 Rev Modification Name Date		Drawing size:	A3	Drawing N. 7111-210-02-00	Sheet: 1 /1

ALL RIGHTS BELONG TO EIE GROUP Srl
NO COPIES, REPRODUCTION OR DISSEMINATION ARE PERMITTED.

Filename: AZ encoder head support.ipt