






NOTE:  
 DEBURRING OF NOT DIMENSIONED EDGES ARE STRICTLY REQUIRED.  
 THE SURFACES NOT MACHINED MUST BE COATED WITH PAINTING TYPE RAL 3016.

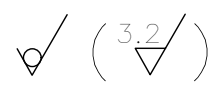

 <b>EIE GROUP</b> via Torino 151A - Mestre Venezia - 30172 - ITALY tel. +39 041 5317906 - www.eie.it		  <b>ASTRI mini-array - CTA Small Size Telescope prototypes</b>															
Material: Construction steel S355J0 EN10027	Surface:	Tolerances according to: ISO 2768/1-m ISO 2768/2-k	Roughness:	Commissa/Job no.: <b>G0113</b>	 <small>VIEWS AND SECTIONS ARE TO BE WORKED WITH REFERENCE TO EUROPEAN DWG SYSTEM</small>												
Status:	Mass: 0,71 kg	Scale: 1:1	Naming: Electro Mechanics Mount assembly AZ Fork Bumper Shim														
	Date:	Name:	Drawing N.														
	Designed 18/01/2018	ACA	7113-000-01-00														
	Checked 21/02/2018	ABU	Sheet:														
	Approved 21/02/2018	GPM	1 / 1														
<table border="1"> <thead> <tr> <th>A</th> <th>First issue</th> <th>ACA</th> <th>04.03.21</th> </tr> <tr> <th>Rev</th> <th>Modification</th> <th>Name</th> <th>Date</th> </tr> </thead> <tbody> <tr> <td> </td> <td> </td> <td> </td> <td> </td> </tr> </tbody> </table>		A	First issue	ACA	04.03.21	Rev	Modification	Name	Date					Drawing size:	A3	Filename: Bumper Shim.ipt	
A	First issue	ACA	04.03.21														
Rev	Modification	Name	Date														
ALL RIGHTS BELONG TO EIE GROUP Srl NO COPIES, REPRODUCTION OR DISSEMINATION ARE PERMITTED.																	