


EIE GROUP

via Torino 151A - Mestre
Venezia - 30172 - ITALY
tel. +39 041 5317906 - www.eie.it

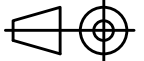

ASTRI mini-array - CTA Small Size Telescope prototypes

Material: EPDM Rubber		Surface:		Tolerances according to: ISO 2768/1-m ISO 2768/2-k		Roughness:		Commissa/Job no.: G0113		 <small>VIEWS AND SECTIONS ARE TO BE WORKED WITH REFERENCE TO EUROPEAN DWG SYSTEM</small>			
Status:				Mass: 0,05 kg		Scale: 1:1		Naming: Electro Mechanics Optical Support Structure M2 BUS Main Structure Rubber Pad					
				Date:		Name:		Drawing N. 7124-000-04-00				Sheet: 1 / 1	
				Designed 21/11/2018		ACA							
				Checked 21/11/2018		ABU							
				Approved 22/11/2018		GPM							
A First issue		ACA 04.03.21		Drawing size:		A4							
Rev Modification		Name Date											

ALL RIGHTS BELONG TO EIE GROUP Srl
NO COPIES, REPRODUCTION OR DISSEMINATION ARE PERMITTED.

Filename: Soft pad.ipt