


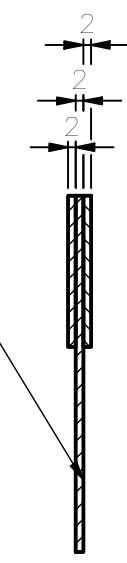

Perforated sheet thk.2 mm  
holes  $\phi 20$ mm pitch 40mm



- NOTES:
- 1) DEBURRING OF NOT DIMENSIONED EDGES ARE STRICTLY REQUIRED
  - 2) THE SURFACES MUST BE COATED WITH PAINTING TYPE RAL 3016 UNLESS OTHERWISE SPECIFIED

 <b>EIE GROUP</b> via Torino 151A - Mestre Venezia - 30172 - ITALY tel. +39 041 5317906 - www.eie.it		  <b>ASTRI mini-array - CTA Small Size Telescope prototypes</b>														
Material: Welded EN AW-5083	Surface:	Tolerances according to: ISO 2768/1-m ISO 2768/2-k	Roughness:	Commissa/Job no.: <b>G0113</b>												
Status:	Mass: 3,22 kg	Scale: 1:5	Naming: Electro Mechanics Optical Support Structure M2 BUS Main Structure M2 shield 1													
<table border="1"> <tr> <td>Designed</td> <td>02/02/2017</td> <td>Name:</td> <td>ABU</td> </tr> <tr> <td>Checked</td> <td>15/10/2018</td> <td>ABU</td> <td></td> </tr> <tr> <td>Approved</td> <td>16/10/2018</td> <td>GPM</td> <td></td> </tr> </table>		Designed	02/02/2017	Name:	ABU	Checked	15/10/2018	ABU		Approved	16/10/2018	GPM		Drawing N.	7124-000-05-00	Sheet: 1 / 1
Designed	02/02/2017	Name:	ABU													
Checked	15/10/2018	ABU														
Approved	16/10/2018	GPM														
<table border="1"> <tr> <td>A</td> <td>First issue</td> <td>ACA</td> <td>04.03.21</td> </tr> <tr> <td>Rev</td> <td>Modification</td> <td>Name</td> <td>Date</td> </tr> </table>		A	First issue	ACA	04.03.21	Rev	Modification	Name	Date	Drawing size:	A3	Filename: M2 shield 1.ipt				
A	First issue	ACA	04.03.21													
Rev	Modification	Name	Date													
ALL RIGHTS BELONG TO EIE GROUP Srl NO COPIES, REPRODUCTION OR DISSEMINATION ARE PERMITTED.																