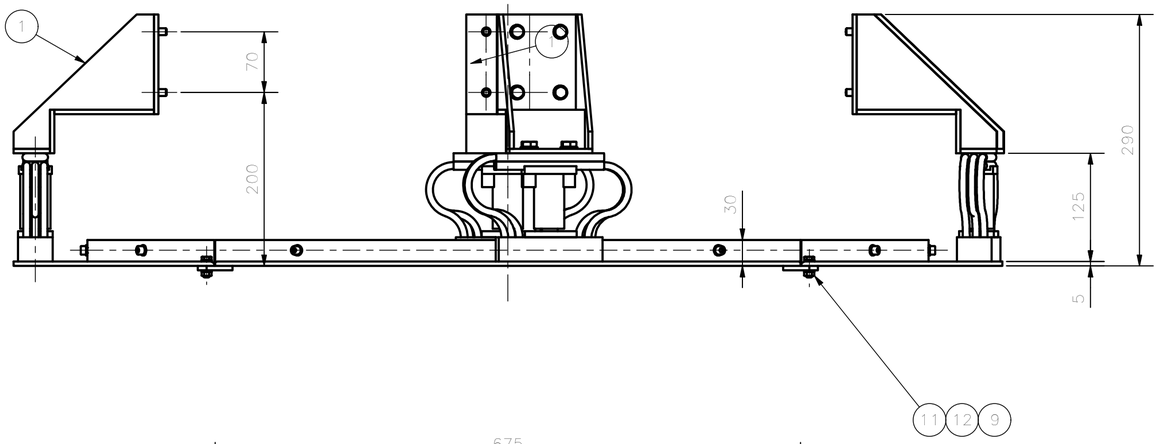

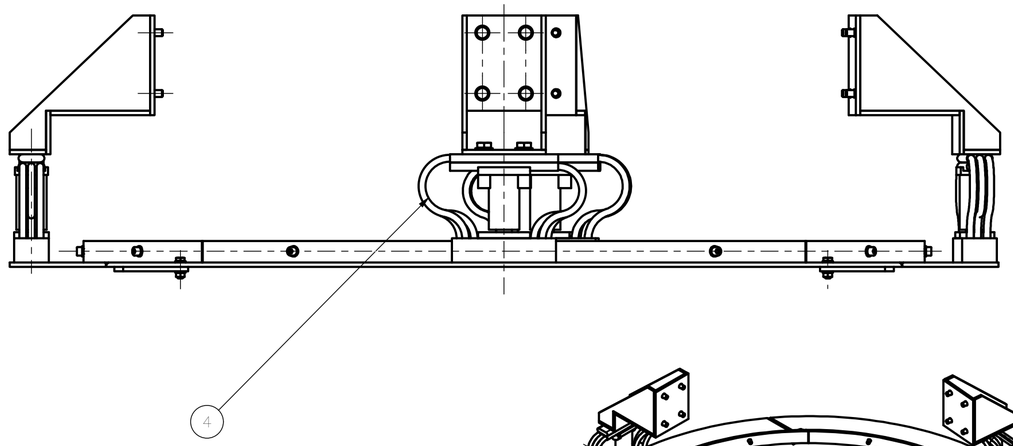

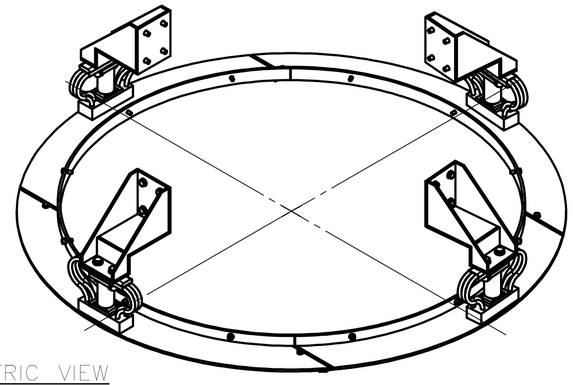

ISOMETRIC VIEW

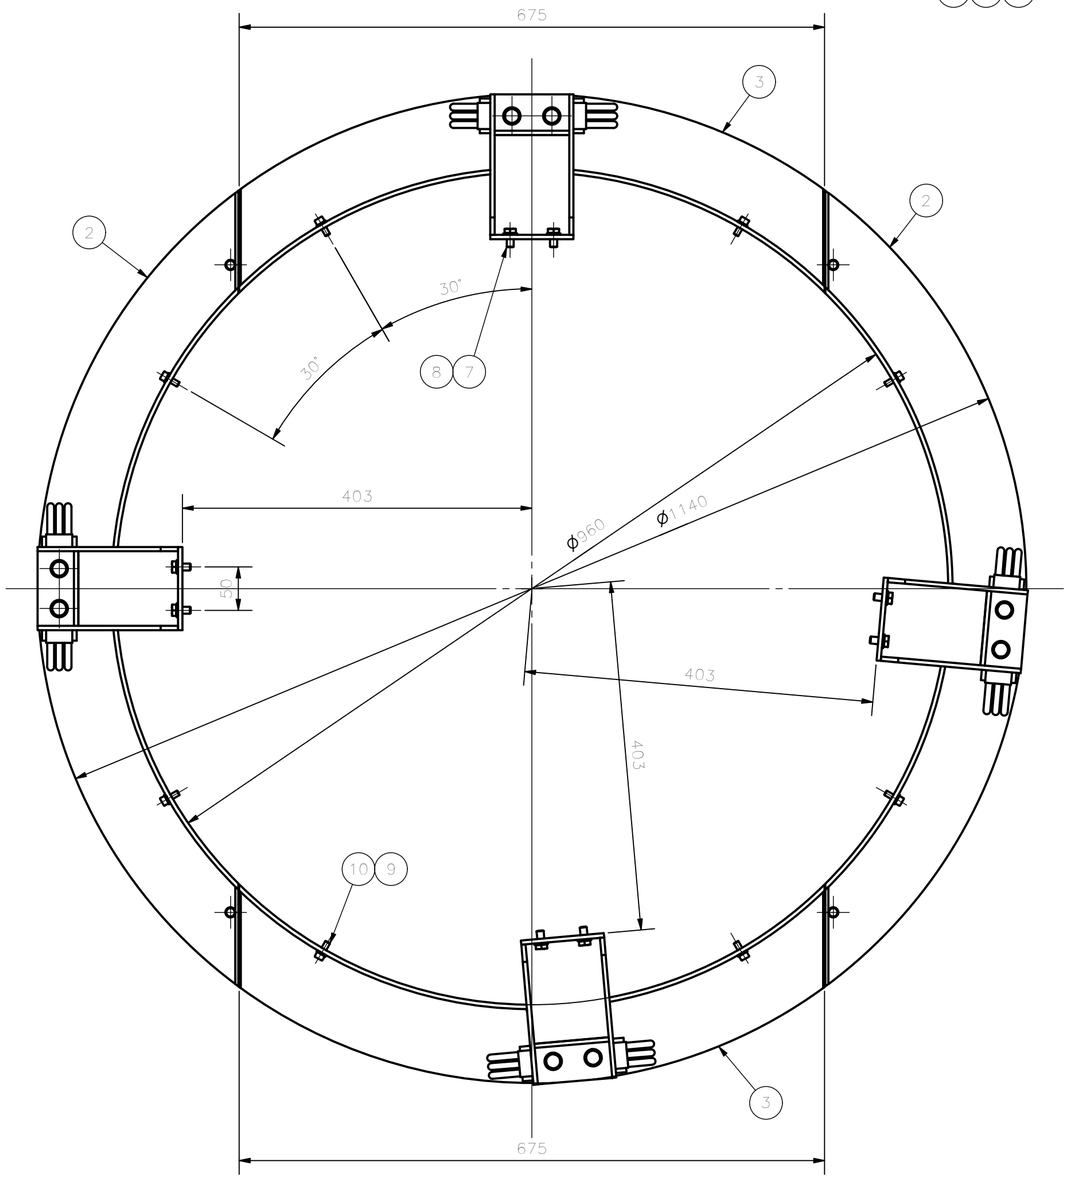

Item	Code	Description	Q.ty	Material	Unit Mass
12	ISO 4017 – M6 x 20	Hexagon head screws	4	cl.8.8 electro galvanized	0,007 kg
11	ISO 4032 – M6	Hexagon nuts	4	cl.8 electro galvanized	0,003 kg
10	ISO 4762 – M6 x 16	Hexagon Socket Head Cap Screw	12	cl.8.8 electro galvanized	0,007 kg
9	ISO 7089 – 6	Plain washers	20	200 HV electro galvanized	0,001 kg
8	ISO 7089 – 8	Plain washers	16	200 HV electro galvanized	0,002 kg
7	ISO 4017 – M8 x 16	Hexagon head screws	16	cl.8.8 electro galvanized	0,012 kg
6	ISO 4017 – M10 x 40	Hexagon head screws	8	cl.8.8 electro galvanized	0,035 kg
5	ISO 7089 – 10	Plain washers	8	200 HV electro galvanized	0,004 kg
4	F 2065 Ident 1423622RL	Brush Holder without radius MORGAN REKOFA	4		0,288 kg
3	7634-110-02-00	LPS AZ track sector 2	2	AISI 316-EN1.4401	3,661 kg
2	7634-110-01-00	LPS AZ track sector 1	2	AISI 316-EN1.4401	4,052 kg
1	7634-110-03-00	LPS AZ brush support	4	Welded construction steel S355J0 EN10027	1,987 kg

EIE GROUP
via Torino 151A - Mestre
Venezia - 30172 - ITALY
tel. +39 041 5317906 - www.eie.it

ASTRI mini-array - CTA Small Size Telescope prototypes

Material:	Surface:	Tolerances according to: ISO 2768/1-m ISO 2768/2-k	Roughness:	Commessa/Job no.: G0113
Status:		Mass: 25,19 kg	Scale: 1:5	Naming: Electrical system / LPS & grounding / LPS & grounding AZ / LPS AZ unit

	Date:	Name:
Designed	09/04/2018	NAN
Checked	16/04/2018	ABU
Approved	17/04/2018	GPM

Rev	Modification	Name	Date
A	First issue	ACA	04.03.21

Drawing size: A2

Drawing N. 7634-110-00-00

Sheet: 1 /1

Filename: LPS AZ unit.iam

VIEWS AND SECTIONS ARE TO BE WORKED WITH REFERENCE TO EUROPEAN DWG SYSTEM

ALL RIGHTS BELONG TO EIE GROUP Srl
NO COPIES, REPRODUCTION OR DISSEMINATION ARE PERMITTED.